Comments sent vide KE/TEG & NESPAK &RE2
Letter No:_____ Date:_____

900 MW BOPS-III Combined Cycle Plant & Associated Transmission Projects,PAKISTAN

The drawing / document has been checked to ensure compliance with the Contract. The approval status shall be interpreted as laid down in theContract and s hall not relieve the Contractor form his contractualobligations.

Cat. 1 [ ]APPROVED
Cat. 2 [ ]APPROVED EXCEPT AS NOTED
Cat. 3 [ ]NOT APPROVED
Cat. 4 [ ]FOR INFORMATION ONLY
COMMENT SHEET NUMBER:_____

DATE:_____

SIGNATURES:_____

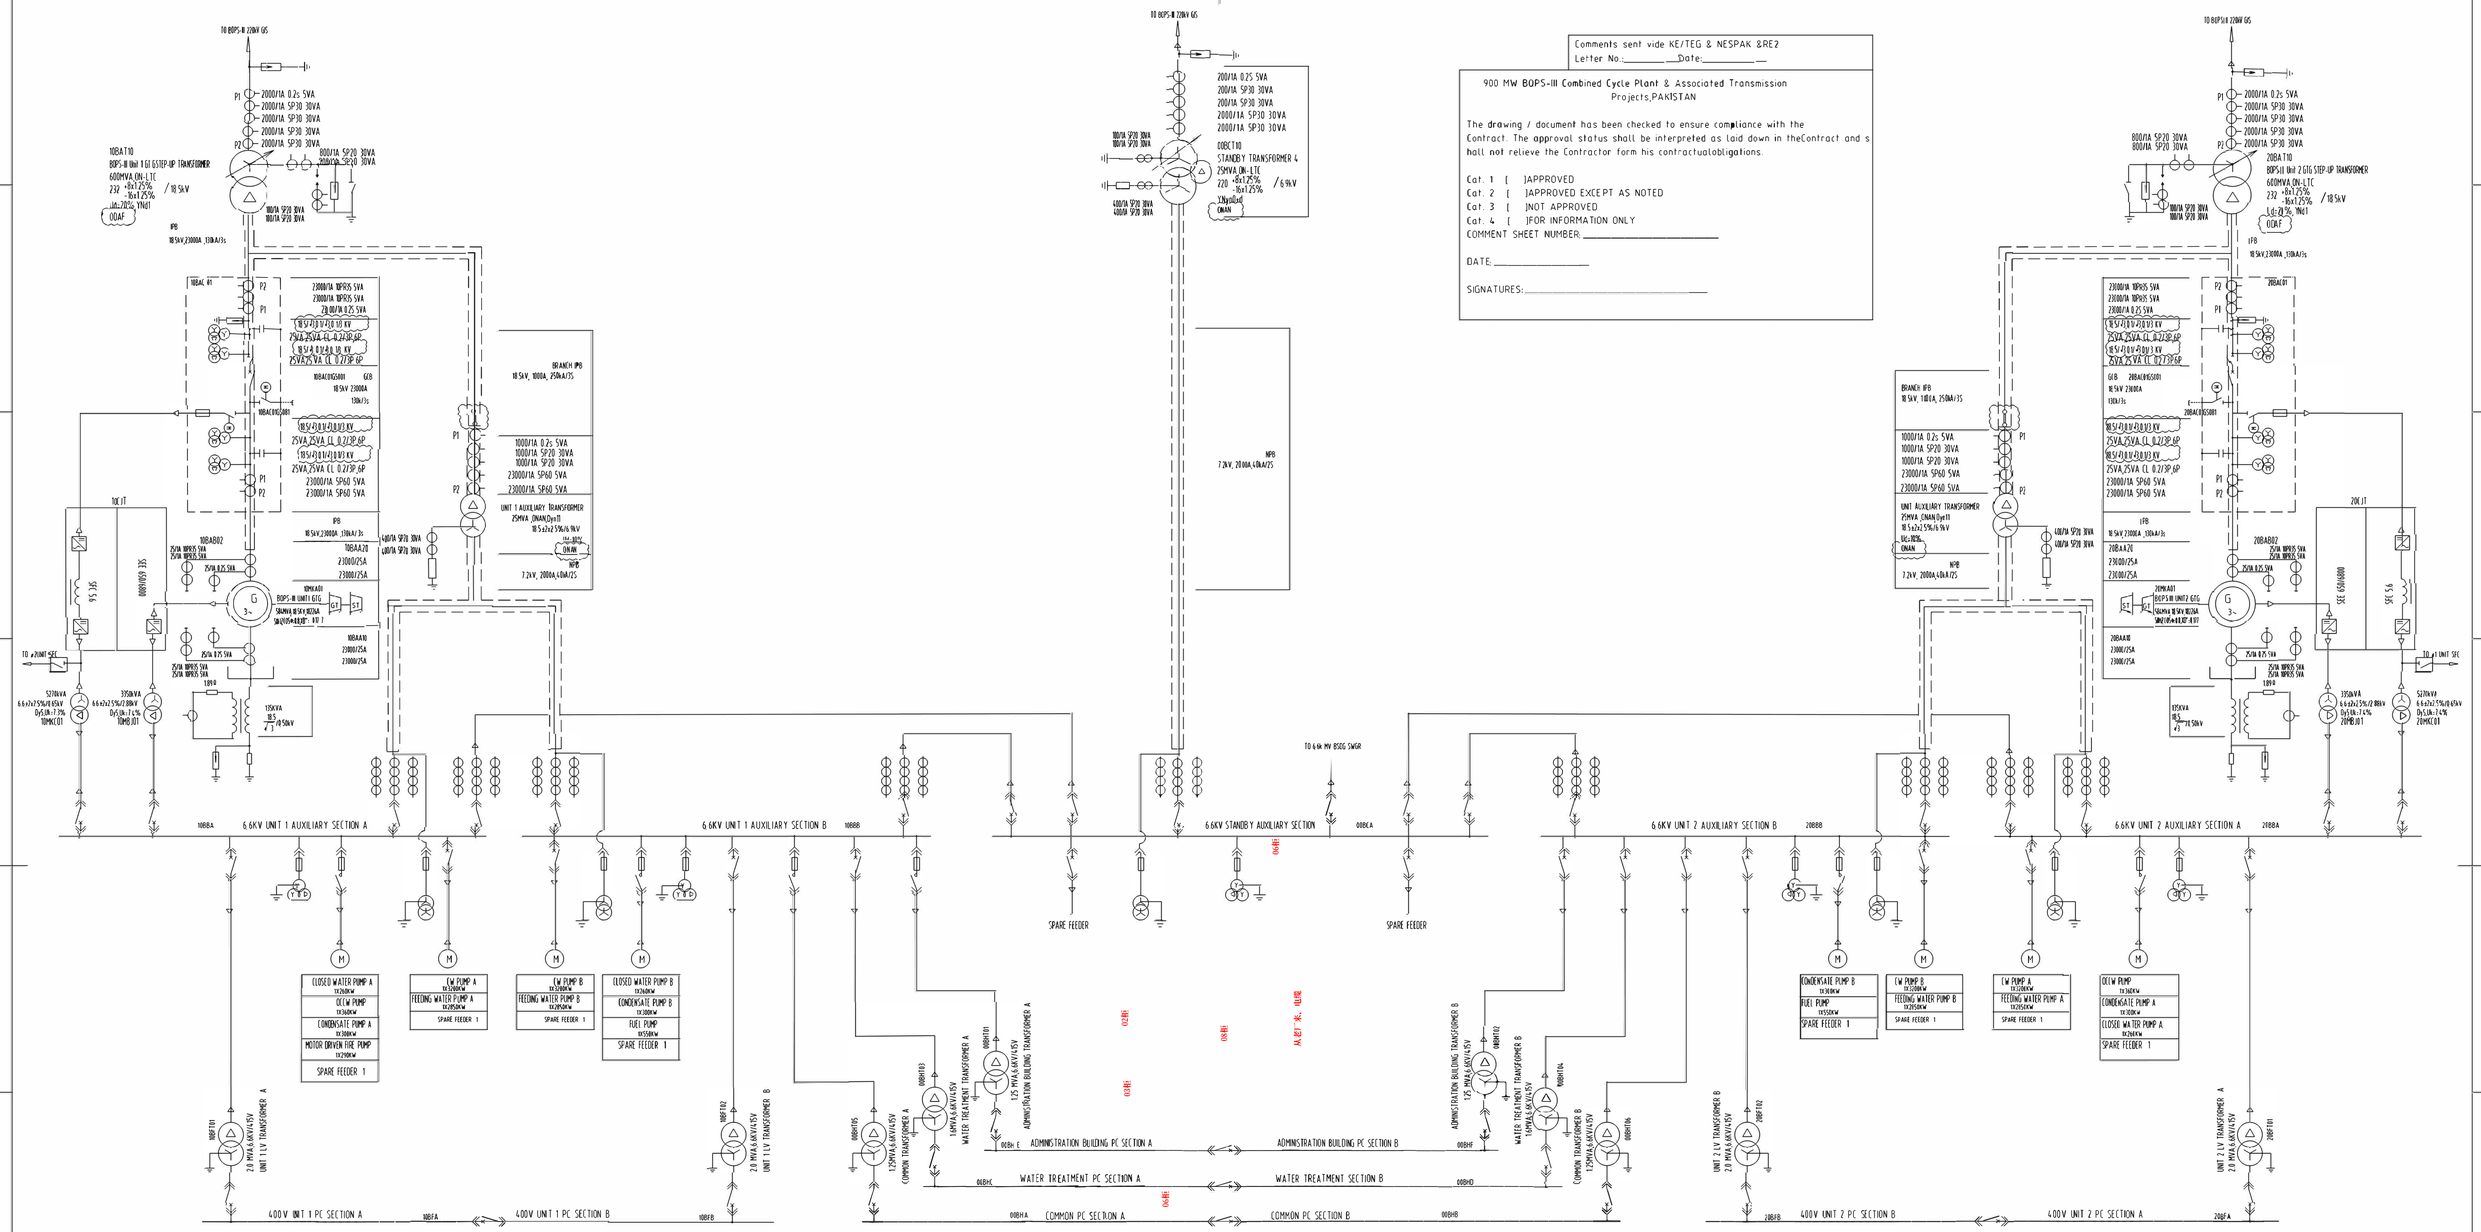

NOTE:1.EQUIPMENT PARAMETERS IN SIEMENS'S SCOPE ARE PRELIMINARY, AND SHALL BE EQUALIZED AS PER SIEMENS'S FINAL DOCUMENTS
2.HIGH SPEED TRANSFER SWITCH IS MENTIONEDED IN DRAWING F08643C-D2-23 PROTECTION SLD FOR 6.6KV AND 0.4KV SWITCHGEAR
3.THE 400 ESSENTIAL PC IS REFERING TO DRAWING F08643C-D02-11 FOR CONNECTION DETAILS
4. BSDG'S CALCULATION WILL BE SUPPLIED IN DETAIL DESIGN AFTER THE BLACK START CONSUMERS CONFIRMED

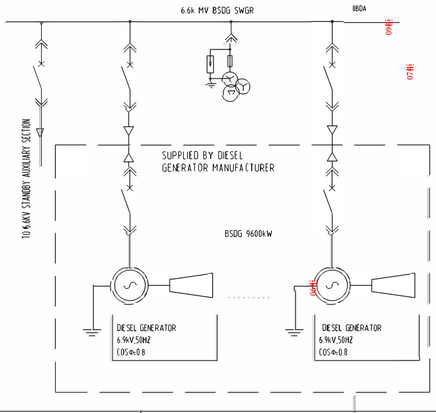

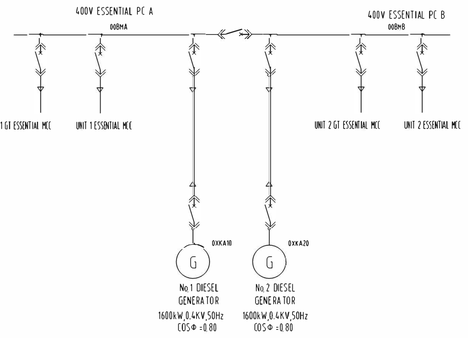

ABBREVIATION LIST:

GT	GAS TURBINE
NGT	NEUTRAL GROUNDING TRANSFORMER
IPB	ISOLATED PHASE BUS
GCB	GENERATOR CIRCUIT BREAKER
VT	VOLTAGE TRANSFORMER
MV	MIEDIUM VOLTAGE
CT	CURRENT TRANSFORMER
NPB	NON-ISOLATED PHASE BUS

LEGEND:

	DISCONNECTOR		ISOLATED PHASE BUSBAR AND MV BUS
	CIRCUIT BREAKER		SURGE ARRESTER
	EARTH		MOTOR
	TRANSFORMER WITH ON LOAD TAP CHANGER		GENERATOR
	SEE SWITCH CUBICLE		CT
	TRANSFORMER		VT
	POWER CABLE		VOLTAGE REGULATOR
	DISCONNECT PART		

专 业	会 签	日 期

REV	DESCRIPTION	PREPARED	CHECKED	REVIEWED	APPROVED
1					
0					

PROJECT: 900 MW BOPS-III Combined Cycle Plant & Associated Transmission Projects
DESIGN STAGE: BASIC DESIGN

APPROVED		CHECKED	
REVIEWED		PREPARED	
DATE		SCALE	

AUXILIARY ELECTRICAL SINGLE LINE DIAGRAM FOR BOPS-III

Dimensions in mm | Drawing Size : A1 | Contractor's DRG. No | F08643C-D02-03 | REV 1